DEDICATION

Know all men by these presents that the undersigned, L&K CONSTRUCTION, LLC and TRONA VALLEY COMMUNITY FEDERAL CREDIT UNION being the owners, proprietors, or parties of interest in the land shown on this plat, do hereby certify:

That the foregoing plat designated as the Boars Tusk Subdivision, is located in the South Half of Section 29, Resurvey Township 20 North, Range 105 West of the Sixth Principal Meridian, Sweetwater County, Wyoming and is more particularly described as

Beginning at the Southwest Corner of said Section 29,

Thence North 00°21'55" West (North 00°21'17" West - deed) along the West Line of said Section 29 for a distance of 2327.54 feet (2326.64 feet - deed) to the southwest corner of the Dennis and Sydney Walker tract described in Book 868, Page 20 in the records of the Sweetwater County Clerk;

Thence South 89°58'13" East (South 89°57'40" East - deed) along the southerly boundary of said Walker tract for a distance of 1381.37 feet (1381.78 feet - deed) to the southwest corner of the Kenneth and Tammy Wolff tract described in Book 866, Page 750 in the records of the Sweetwater County Clerk;

Thence South 89°58'13" East (South 89°57'40" East - deed) along the southerly boundary of said Wolff tract for a distance of 1138.15 feet (1137.92 feet - deed) to the northwest corner of the Brian Stouffer tract described in Book 920, Page 154 in the records of the Sweetwater County Clerk;

Thence South 00°10'13" East (South 00°08'46" East - deed) along the westerly boundary of said Stouffer tract for a distance of 1004.36 feet (1004.48 feet - deed) to the southwest corner thereof;

Thence North 89°59'12" East (North 89°59'27" East - deed) along the southerly boundary of said Stouffer tract for a distance of 120.56 feet:

Thence South 89°59'49" East (South 89°59'33" East - deed) along the southerly boundary of said Stouffer tract for a distance of 752.15 feet (752.39 feet - deed) to the northwest corner of the Russell \$ Robin Robison tract described in Book 866. Page 464 in the records of the Sweetwater County Clerk;

Thence South 00°07'49" East (South 00°06'34" East - deed) along the westerly boundary of said Robison tract for a distance of 1319.91 feet (1320.00 feet - deed) to the southwest corner thereof, said point lies on the South Line of said Section 29:

Thence South 89°53'09" West (North 89°59'33" West - deed) along said south line of said Section 29 for a distance of 749.85 feet (751.55 feet - deed) to the South Quarter Corner thereof;

Thence South 89°59'27" West along the south line of said Section 29 for a distance of 2633.53 feet (2631.78 feet - deed) to the POINT OF BEGINNING.

Said parcel contains an area of 160.81 acres (160.73 acres - deed), and

That said subdivision as it is described and as it appears on this plat is made with the free consent and in accordance with the desires of the undersigned owner and proprietor; and that this is a correct plat of the area as it is divided into lots, blocks, streets, and utility easements, and That the undersigned owner of the land shown and described on this plat does hereby dedicate to the public use all streets, alleys, easements, and other lands within the boundary lines of the plat as indicated and not already otherwise dedicated for public use. All rights under and by virtue of the Homestead Exemption laws of the State of Myoming are hereby waived and released.

L&K CONSTRUCTION. LLC P.O. BOX 1449 GREEN RIVER, WYOMING 82935

STATE OF WYOMING SMEETMATER COUNTY

as a free and voluntary act and deed.

Witness my hand and official seal My commission expires 13/16/07

Notary Public



The undersigned, being an Owner of Interest in the Land Presently Being Platted as the Boars Tusk Subdivision, do hereby ratify and join in all provisions of the Certificated of Dedication attached to said Plat as fully and completely as if we had executed the original Certificate of Dedication.

We do specifically dedicate the use of the streets, easements and public areas to the General Public.

TRONA VALLEY COMMUNITY FEDERAL CREDIT UNION 840 HITCHING POST DRIVE GREEN RIVER, WYOMING 82935

KELLY PARMER VICE-PRESIDENT

HELBORG - NOTARY PUBLIC

STATE OF WYOMING

SWEETWATER COUNTY The foregoing instrument was acknowledged before me this 4th day of 4ptl, by: Kelly Yalner

as a free and voluntary act and deed.

Witness my hand and official seal

My commission expires 12/16/07 this 6. hillorg Notary Public

ALICE E. TIELBORG - NOTARY PUBLIC COUNTY OF STATE OF WYOMING

RESOLUTION 06-02-ZO-04 - FEES IN LIEU OF LAND VARIANCE


PRELIMINARY PLAT AUTHORIZATION NUMBER 06-01-PZ-01

SUBDIVISION VARIANCES RESOLUTION 05-11-ZO-01 - LOTS VARIANCE 8d(1)(4)(5)(6)

FINAL PLAT BOARS TUSK SUBDIVISION

SOUTH HALF, SECTION 29, TOWNSHIP 20 NORTH, RANGE 105 WEST

SMEETMATER COUNTY, MYOMING

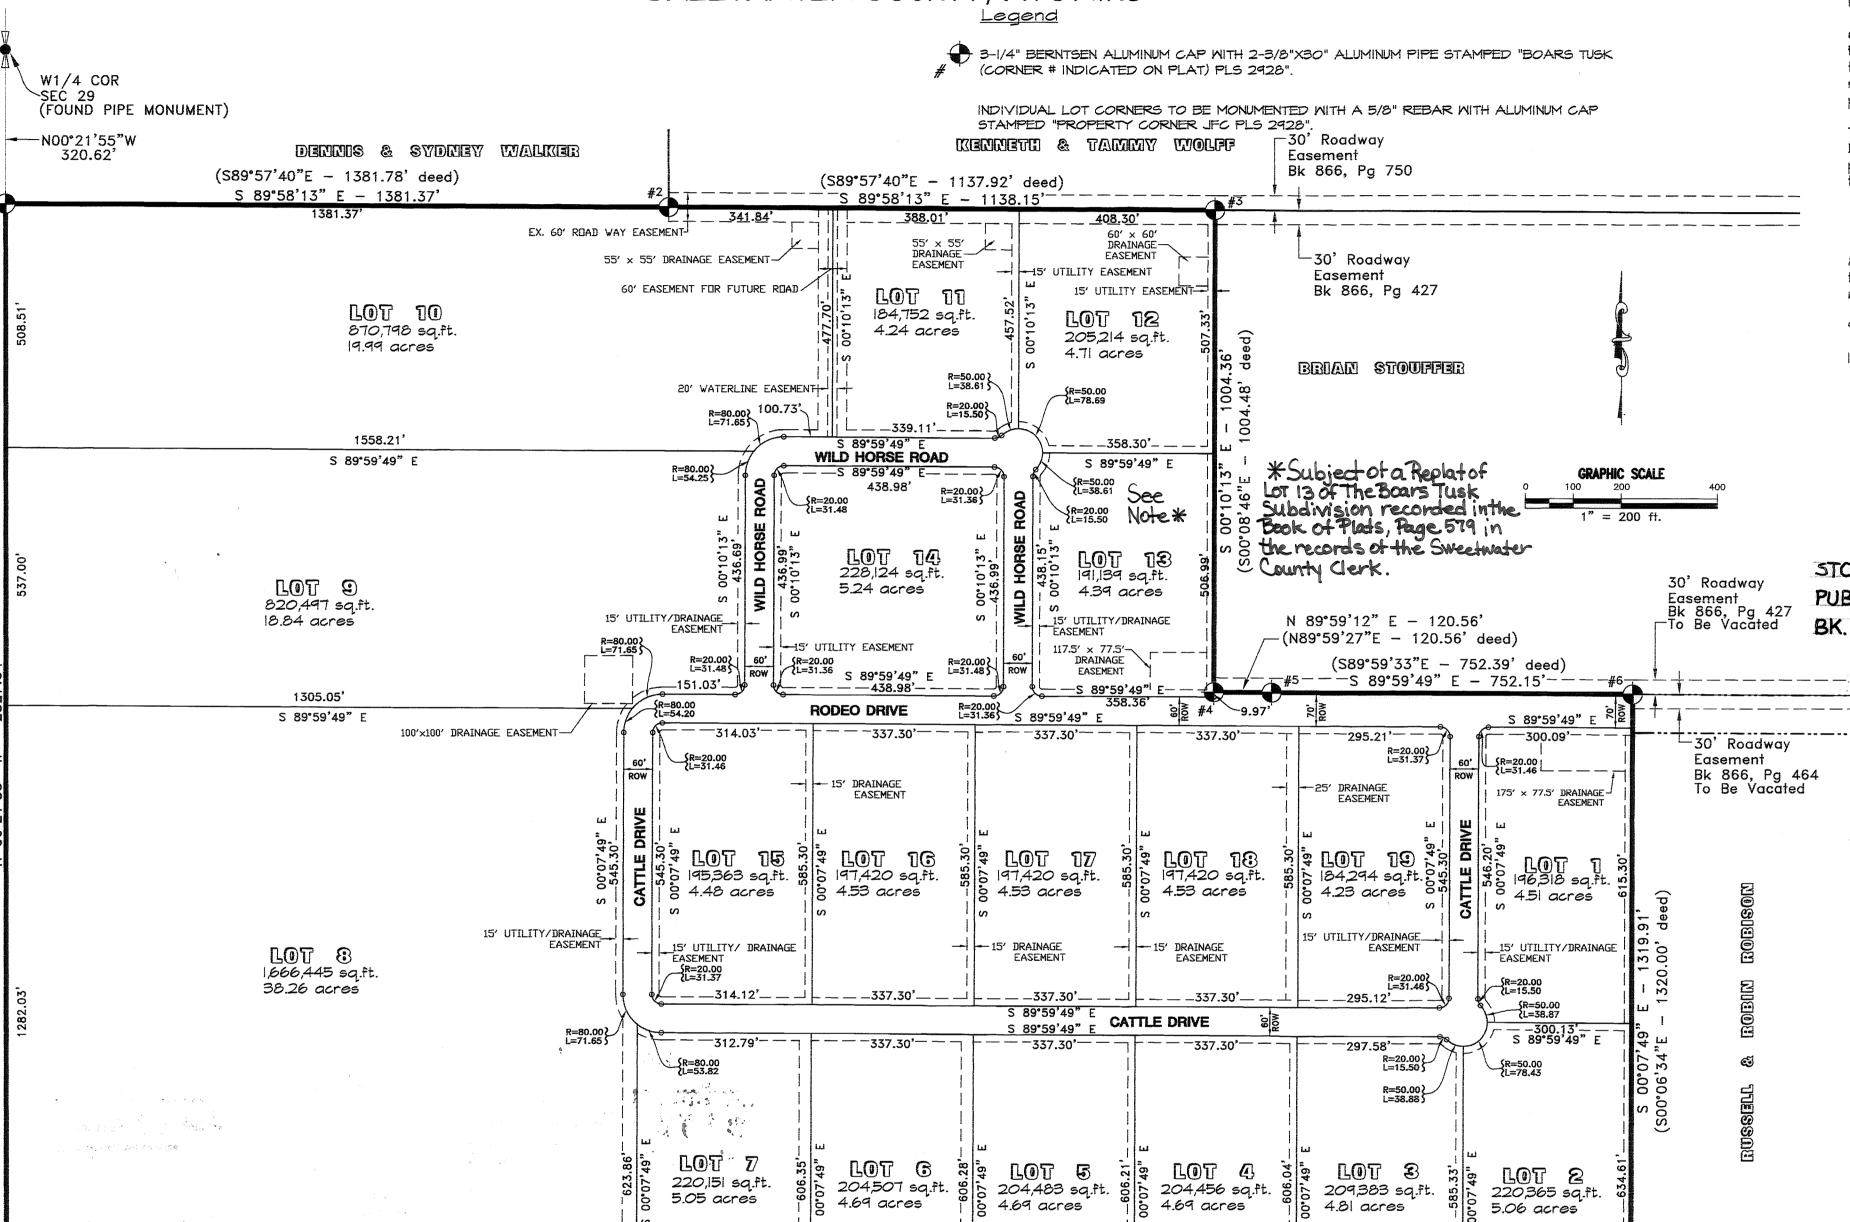

Certificate of Surveyor


POB, ELEV 7070.40

(PIPE MONUMENT FOUND)

314 32

Date:

1, Joseph W. Manatos, do hereby certify that I am a Land Surveyor registered under the laws of the State of Myoming, and that this plat is a true, correct, and complete plat of the BOARS TUSK SUBDIVISION, as laid out, platted, dedicated, and shown hereon, that such plat was made from an accurate survey of said property by me and under my supervision and correctly shows the location and dimensions of the lots, easements, and streets of said subdivision as the same are staked upon the ground in compliance with Sweetwater County regulations governing the subdivision of land.

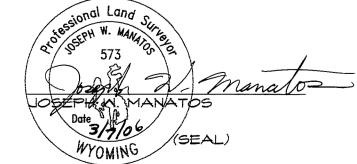

Professional Land Surveyor Registration Number 573

Approval - Sweetwater Planning and Zoning Commission

SOUTH LINE OF SECTION 29

This plat approved by the Sweetwater County Planning and Zoning Commission this ______, and ______, 2006

DRAINAGE

EASEMENT

EASEMENT 53.08'

D' DRAINAGE EASEMENT

(2631.78' deed)

<u> Approval – County Engineer</u>

Approved this 7th day of Mar, 20 County Engineer of Sheetmater County, Myoming. Sneetwater doubti

Acceptance and Approval Sweetwater County Board of Commissioners

(N89°59'33"W - 751.55' deed)

SEC 29 (FOUND PIPE MONUMENT)

S1/4 COR

all improvements shall have been completed to the satisfaction of the Board of County Commissioners.

EASEMENT


PALLESEN, CHAIRMAN

LAND OWNER/DEVELOPER L&K CONSTRUCTION, LLC P.O. BOX 1449 GREEN RIVER, WYOMING 82935

- 1. This subdivision contains 19 residential lots and includes a total of 160.81 acres, including 9.33 acres within the street right-of-way.
- 2. This property is zoned R-2/SF2, Single Family Residential.
- 3. Individual lot owners are required to submit a Drainage Plan at the time of Application for a Construction/Use Permit for the primary residential permitted use. This Drainage Plan must be approved and stamped by a Myomina Professional Engineer. The applicant/property owner is responsible for implementing and maintaining the drainage plan.
- 4. NO WATER RIGHTS ARE CONVEYED WITH THIS PROPERTY.
- 5. SOILS REPORT "Since soil conditions may vary significantly at each lot, a aeotechnical engineer should inspect each excavation to verify soil types and identify potential problem soils."
- 6. Maintenance and upkeep of drainage easements outside the County Right-of-Way will be the responsibility of the individual lot owner. Fences, walls or footings that would impede drainage flows within those drainage easements and regrading of drainage easements shall not be permitted. Drainage ditches that parallel the roads will be maintained by the county.
- 7. Individual lot owners shall obtain Chapter 3 Permit to Construct from the MDEQ-MQD to authorize the construction of a septic system with leach field. The permit application must be submitted by a Professional Engineer Licensed with the State of Myoming to: Southwest District Engineer Water Quality Division 510 Meadonview Drive
- 8. Lot ! frontage will be located to the west. Lot !4 frontage will be located to the north. Lot 13 frontage will be located to the west. Lots 15 thru 19 frontage will be located to the south.

Lander, WY 82520

- 9. NO PROPOSED CENTRALIZED SEWAGE SYSTEM.
- 10. Ten-Mile Water \$ Sewer District will supply the water for the subdivision.

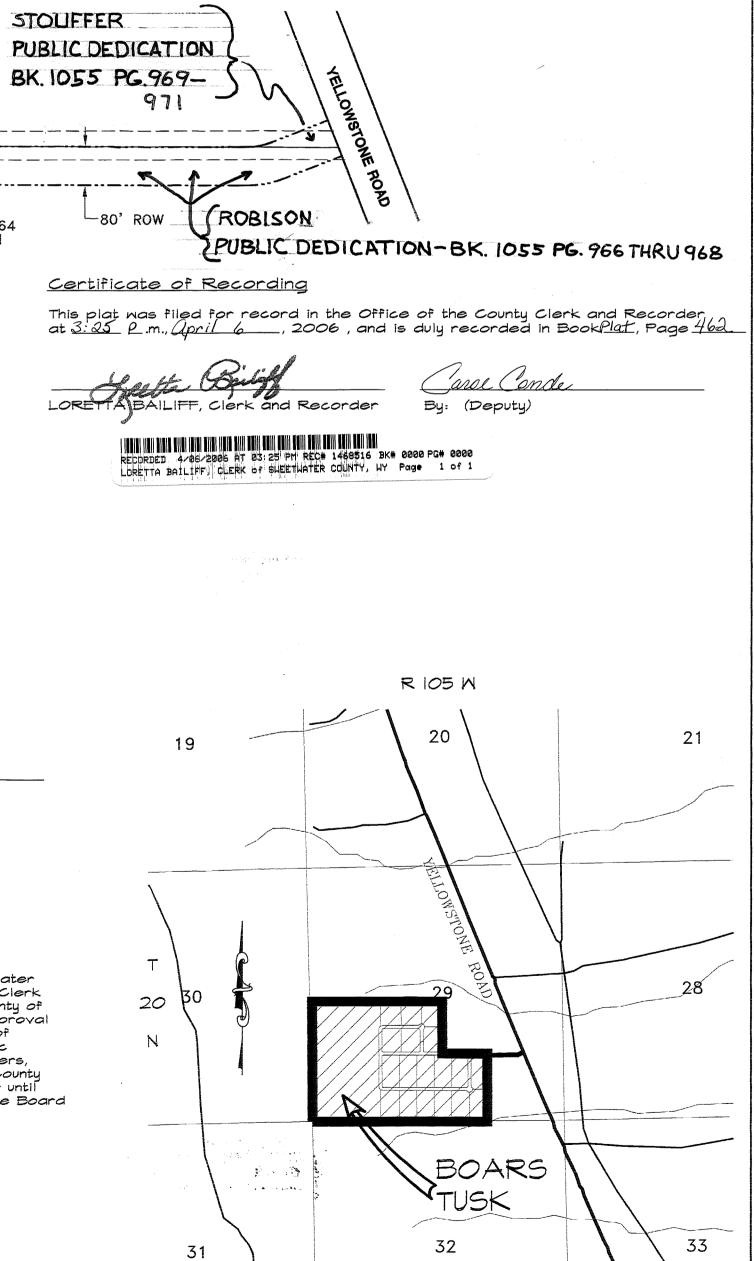

VICINITY MAP

SCALE: |" = 2000'

JANUARY 2006